

# CODE NOTES:

## A3 OCCUPANCY

TOTAL = 3840 SF  
 1ST FLR. = 3460 SF  
 SEATING AREA = 1100 + 500  
 BALCONY = 380 SF


OCCUPANT LOAD (DL) = 183

TOTAL REQ'D EGRESS WIDTH PER DL = 56.1"  
 TOTAL EGRESS WIDTH SUPPLIED = 136"

## ALTERNATIVE USE D.L.:

OCCUPANT LOAD (DL) = 248  
(96 BENCH SEAT, 44 BALCONY, 34 TABLES, 10 STANDING, 65 STAGE AREA-7 NET)

TOTAL REQ'D EGRESS WIDTH PER DL = 74.4"  
 TOTAL EGRESS WIDTH SUPPLIED = 136"

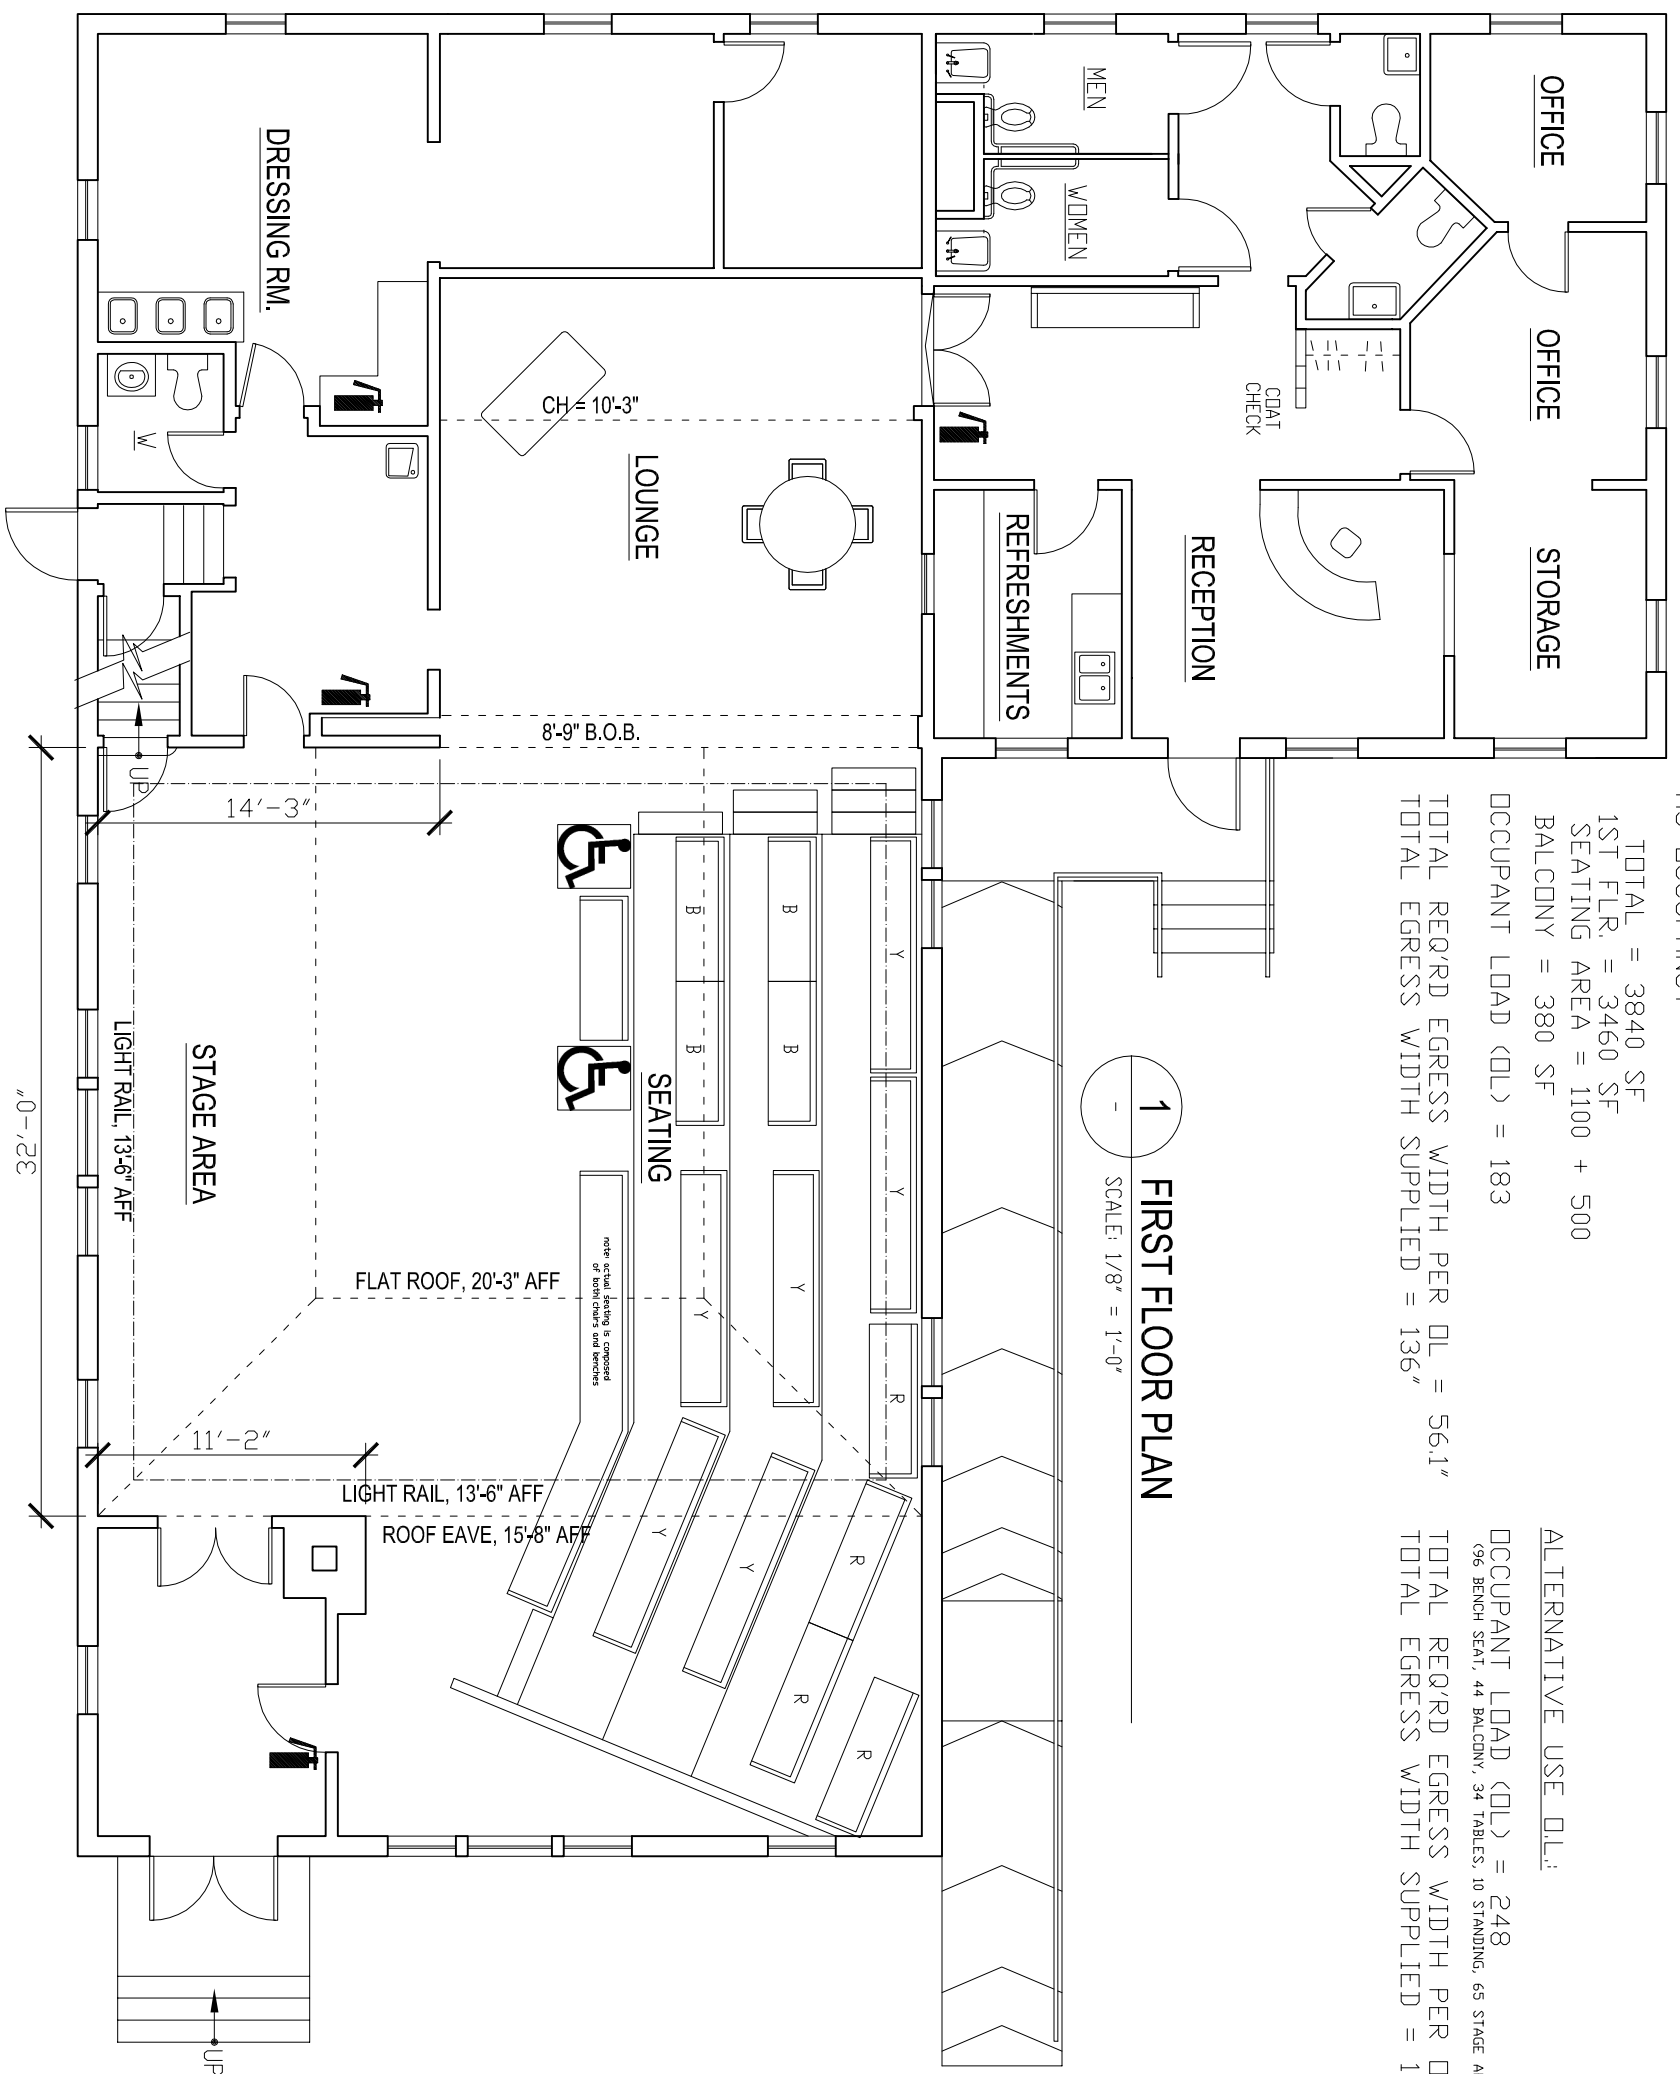

**9x30 Design**  
 Architecture  
 314 Hollywod Avenue  
 Rochester, NY 14618  
 (Ph) 585.242.0501  
 (fax) 585.271.7304  
 Info @ 9x30.com  
 www.9x30.com

142 ATLANTIC AVENUE  
 ROCHESTER NY 14607

AS-BUILT PLAN

DATE: 5.13.16

SCALE: 1/8" = 1'-0"

DRAWN BY: CAC

rev8

AS-BUILT PLAN

A011